

LABOR AND MATERIALS


1 Copper } Connection <sup>3/4"</sup> \$  
 Lead }  
 1 Curb } Cock } <sup>3/4" oriseal</sup> \$  
           } Valve }  
           } T. S. & V. }  
 1 Service box } { Short 3 1/2 x 4 1/2 }  
 Old returned } { Long 4 1/2 x 5 1/2 }  
                   } { Buff or Rdway } \$  
 10 Ft. <sup>3/4</sup> in. } { Copper } Pipe at \$  
                   } { G. I. }  
                   } { C. I. }  
 \_\_\_\_\_ Nipples \_\_\_\_\_ in. at \$  
 \_\_\_\_\_ Bushings \_\_\_\_\_ to \_\_\_\_\_ in. at \$  
 \_\_\_\_\_ Red'g }  
 \_\_\_\_\_ Inc'g } Coupl'gs \_\_\_\_\_ to \_\_\_\_\_ in. at \$  
 \_\_\_\_\_ Union \_\_\_\_\_ in. at \$  
 \_\_\_\_\_ Meter \_\_\_\_\_ in. at \$  
 \_\_\_\_\_ Lead Joints at \$  
 \_\_\_\_\_ Compound Joints at \$  
 \_\_\_\_\_ Maintenance Foreman \$  
 \_\_\_\_\_ Hrs. Water Maint. Man—1 at \$  
 \_\_\_\_\_ Hrs. Water Maint. Man—2 at \$  
 \_\_\_\_\_ Hrs. Garage Foreman \_\_\_\_\_ at \$  
 \_\_\_\_\_ Hrs. Labor— \_\_\_\_\_ at \$  
 \_\_\_\_\_ Hrs. Compressor at \$  
 \_\_\_\_\_ Compensation Ins. at \$ \_\_\_\_\_ per C. \$  
 \_\_\_\_\_ Trucking \$  
 \_\_\_\_\_ Pav't Patch \$  
 Tap by Gifford & Co \$  
 6-17-63 \$  
 \_\_\_\_\_ O'head \$  
 \_\_\_\_\_ \$

Grave

St. \_\_\_\_\_  
 Pl. \_\_\_\_\_  
 Ave. No. 54 1/2

Name of Owner  
 First Wesleyan M. E. Ch.

Labor and Mat'l. Report June 17 1963

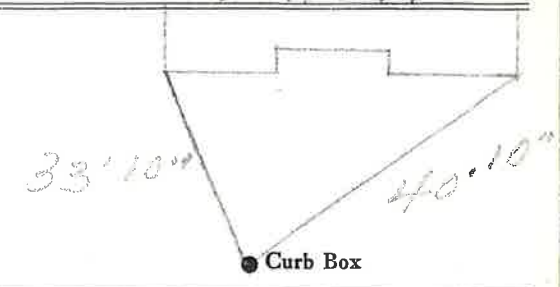

6" C-10 Main Elev. of Main at tap 4'

Gate at ● ● Gate at

● Curb Box