

LABOR AND MATERIALS

1	Copper	{ Connection	3/4"	\$	2.76
	Lead				
1	Curb	{ Cock Valve	3/4 in.	\$	3.49
		{ T. S. & V.			
1	Service box	{ Short 3 1/2 X 4 1/2		\$	4.74
	Old returned	{ Long 4 1/2 X 5 1/2			
		{ Buff or Rdway			
28	Ft.	{ Copper	Pipe at 38	\$	10.64
		{ C. I.			
		{ C. I.			
	Nipples	in. at		\$	
	Bushings	to in. at		\$	
	Red'g			\$	
	Inc'g	{ Coupl'gs	to in. at	\$	
	Union	in. at		\$	
	Meter	in. at		\$	
	Lead Joints at			\$	
	Compound Joints at			\$	
	Hrs. Water Maint. Man-1 at			\$	
4	Hrs. Water Maint. Man-2 at	1.24		\$	4.96
8	Hrs. Labor-	at 1.13		\$	9.04
	Hrs. Labor-	at		\$	
	Hrs. Compressor at			\$	
	Compensation Ins. at \$4.406 per C			\$	62
	Trucking			\$	1.00
	Pay't Patch			\$	18.00
	Tap by Gissoid 7-8-53			\$	
	O'head			\$	
				\$	55.25

37.25

1.400


55-53

61-63

Str: Ave. No. 57

Grove
Name of Owner M. Ash MINOR

Labor and Mat'l. Report July 8 1953

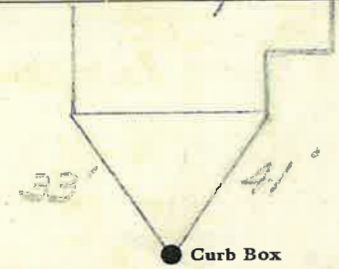

6" Main Elev. of Main at tap 5 1/2'

Gate at ● Gate at ●

● Curb Box
#61 TAX ID # 302.19-18-12