


LABOR AND MATERIALS

1	Copper Lead	Connection	3/4"	\$	
1	Curb	Cock Valve T.S. & V.	3/4" in.	\$	
1	Service box Old returned	Short 3 1/2 x 4 1/2 Long 4 1/2 x 5 1/2 Buff or Rdway		\$	
9	Ft. 3/4 in.	Copper G.I. C.I. } Pipe at		\$	
	Nipples	in. at		\$	
	Bushings	to in. at		\$	
	Red'g Inc'g } Coupl'gs	to in. at		\$	
	Union	in. at		\$	
	Meter	in. at		\$	
	Lead Joints at			\$	
	Compound Joints at			\$	
	Maintenance Foreman			\$	
	Hrs. Water Maint. Man-1	at		\$	
	Hrs. Water Maint. Man-2	at		\$	
	Hrs. Garage Foreman	at		\$	
	Hrs. Labor	at		\$	
	Hrs. Compressor at			\$	
	Compensation Ins. at \$	per C		\$	
	Trucking			\$	
	Pav't Patch			\$	
	Tap by Gissard			\$	
	4 Coil 8-9-62			\$	
	O'head			\$	
				\$	

St. Grove
Pl. 67
Ave. No. 67

Name of Owner Harold Hogan

Labor and Mat'l. Report Aug. 9 1962

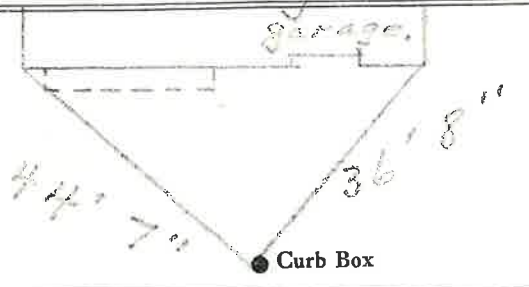

6" Cat Main Elev. of Main at tap 5'

Gate at ● Gate at ●

● Curb Box