

LABOR AND MATERIALS

1	Copper	} Connection	3/4"	\$	_____
1	Curb		} Cock valve T.S. & V.	3/4" in.	\$
1	Service box	} Short 3-1/2 x 4-1/2 Old standard Long 4-1/2 x 5-1/2			\$
11	Ft.		} Copper	3/4 in.	\$
	Nipples			_____ in. at	\$
	Bushings		_____ to _____ in. at	\$	_____
	Red'g				_____
	Inc'g				_____
	Union		_____ in. at	\$	_____
	Meter		_____ in. at	\$	_____
				\$	_____
	Compound Joints at			\$	_____
	Maintenance Foreman			\$	_____
	Hrs. Water Maint. Man - 1 at			\$	_____
	Hrs. Water Maint. Man - 2 at			\$	_____
	Hrs. Garage Foreman		_____ at	\$	_____
	Hrs. Labor		_____ at	\$	_____
	Hrs. Compressor at			\$	_____
				\$	_____
	Trucking			\$	_____
	Pav't Patch			\$	_____
				\$	_____
				\$	_____
				\$	_____
				\$	_____


GROVE

Ave. No. 12

Name of Owner

MCCANN

Labor and Mat'l. Report 19 37, MAY 11

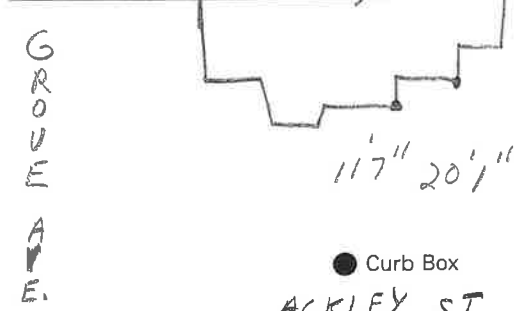

● Curb Box
 ACKLEY ST.
 Elev. of Main at tap 4 1/2'

4" Main

Gate at ● Gate at

● Curb Box

OLD TAP SHUT OFF