

LABOR AND MATERIALS

1	Copper Lead	Connection	$\frac{3}{4}$ "	\$	2.71
1	Curb	Cock Valve T.S. & V.	$\frac{3}{4}$ in.	\$	3.83
1	Service box	Short $3\frac{1}{2}$ x $4\frac{1}{2}$			
	Old returned	Long $4\frac{1}{2}$ x $5\frac{1}{2}$			
		Buff. or Rdway.		\$	4.69
24	Pt. $\frac{3}{4}$ in.	Copper Pipe at	$\frac{1}{2}$	\$	10.80
		G.I.			
		G.I.			
	Nipples	in. at		\$	
	Bushings	to in. at		\$	
	Red'g				
	Inc'g	Coupl'gs to in. at		\$	
	Union	in. at		\$	
	Meter	in. at		\$	
	Lead Joints	at		\$	
	Compound Joints	at		\$	
8	Maintenance Foreman		1.51	\$	12.08
	Hrs. Water Maint. Man-1	at		\$	
2	Hrs. Water Maint. Man-2	at	1.24	\$	2.48
	Hrs. Garage Foreman	at		\$	
8	Hrs. Labor	at	1.13	\$	9.04
	Hrs. Compressor	at		\$	
	Compensation Ins. at \$	4.29 per C.		\$	1.02
	Trucking			\$	1.50
	Pav't Patch			\$	13.50
	Tap by G.I. Ford	12-29-55		\$	
				\$	
				\$	
	O'head			\$	
				\$	61.65

48.15

Grove


St. 65
Pt. 70
Ave. No. 70

Name of Owner

Jones

Labor and Mat'l. Report

Dec 29 1955

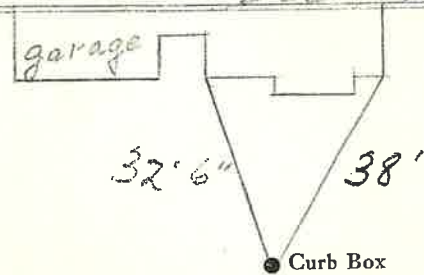

6" Main

Elev. of Main at tap 5 1/2'

Gate at ●

● Gate at

● Curb Box