

LABOR AND MATERIALS

1 Copper } Connection 3/4" \$ _____
 lead }
 1 Curb } Cock } 3/4" in. ORISEAL \$ _____
 Valve }
 T.S. & V. }
 1 Service box { Short 3-1/2 x 4-1/2 } \$ _____
 Old returned { long 4-1/2 x 5-1/2 }
 10 Ft. 3/4 in. { Copper } Pipe at _____ \$ _____
 Nipples _____ in. at _____ \$ _____
 Bushings _____ to _____ in. at _____ \$ _____
 Red'g _____
 Inc'g _____
 Union _____ in. at _____ \$ _____
 Meter _____ in. at _____ \$ _____
 _____ \$ _____
 Compound Joints at _____ \$ _____
 Maintenance Foreman _____ \$ _____
 Hrs. Water Maint. Man - 1 at _____ \$ _____
 Hrs. Water Maint. Man - 2 at _____ \$ _____
 Hrs. Garage Foreman _____ at _____ \$ _____
 Hrs. Labor _____ at _____ \$ _____
 Hrs. Compressor at _____ \$ _____
 _____ \$ _____
 Trucking _____ \$ _____
 Pav't Patch _____ \$ _____
 _____ \$ _____
 _____ \$ _____
 _____ \$ _____
 _____ \$ _____


GROVE

St. Ave. No. 13

Name of Owner

H. BARBER

Labor and Mat'l. Report 1971, NOV. 9

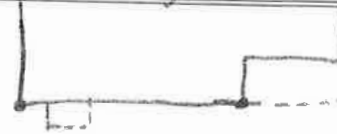

28'6" 33'6"

● Curb Box

6" Main

Elev. of Main at tap 5'

Gate at ●

● Gate at

TAX ID # 302.20-2-16

● Curb Box