

LABOR AND MATERIALS

Copper	} Connection		\$
Lead			
Curb	} Cock Valve T. S. & V.	in.	\$
Service box		} Short 3½ x 4½ Long 4½ x 5½	
Old returned			
24 Ft.	} Copper C.I. C.I.	3/4 in.	Pipe at \$
Nipples		in.	at \$
Bushings	to	in.	at \$
Red'g } Inc'g }	} Coupl'gs	to	in. at \$
Union		in.	at \$
Meter	in.	at \$	
			\$
Compound Joints			at \$
Maintenance Foreman			\$
Hrs. Water Maint. Man—1			at \$
Hrs. Water Maint. Man—2			at \$
Hrs. Garage Foreman			at \$
Hrs. Labor—			at \$
Hrs. Compressor			at \$
			\$
Trucking			\$
Pav't Patch			\$
			\$
			\$
			\$
			\$


GROVE

Str. _____
Pl. _____
Ave. No. 16

Name of Owner _____

Labor and Mat'l. Report

19

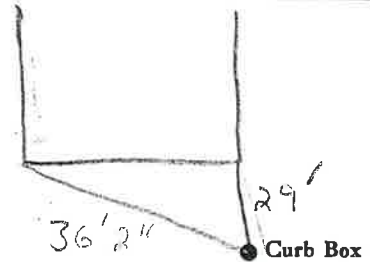

Main _____ Elev. of Main at tap _____

Gate at • _____ Gate at • _____

• Curb Box

GALV. ON THEIR SIDE