


St. PH. Ave. No. 17

Grove

Name of Owner

Renewal 5/97

Labor and Mat'l. Report AUG 24 1939 19

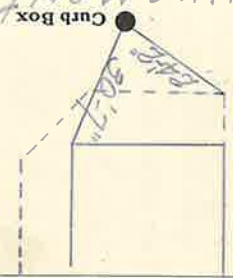

See below
for MEASUREMENTS also

6" Main Elev. of Main at tap

Gate at Gate at

