


LABOR AND MATERIALS

1 Copper } Connection 3/4 \$ _____
~~Lead~~ }
 1 Curb } Cock } 3/4 in. \$ _____
 } Valve }
 } T.S. & V. }
 1 Service box { Short $3\frac{1}{2} \times 4\frac{1}{2}$ }
 Old returned { Long $4\frac{1}{2} \times 5\frac{1}{2}$ } \$ _____
 } Buff. or Rdway }
 30 Ft. 3/4 in. { Copper } Pipe at \$ _____
 } G.I. }
 } C.I. }
 Nipples in. at \$ _____
 Bushings to in. at \$ _____
 Red'g } Coupl'gs to in. at \$ _____
 Inc'g }
 Union in. at \$ _____
 Meter in. at \$ _____
 Lead Joints at \$ _____
 Compound Joints at \$ _____
 Maintenance Foreman \$ _____
 Hrs. Water Maint. Man-1 at \$ _____
 Hrs. Water Maint. Man-2 at \$ _____
 Hrs. Garage Foreman at \$ _____
 Hrs. Labor at \$ _____
 Hrs. Compressor at \$ _____
 Compensation Ins. at \$ per C \$ _____
 Trucking \$ _____
 Pav't Patch \$ _____
 Tap by Giggardt \$ _____
 Co. 6-24-60. \$ _____
 O'head \$ _____
 \$ _____

~~St.~~
 Halsey Pl.
~~Ave. No.~~ 5

Name of Owner Kelly Bros.

Labor and Mat'l. Report June 24 1960

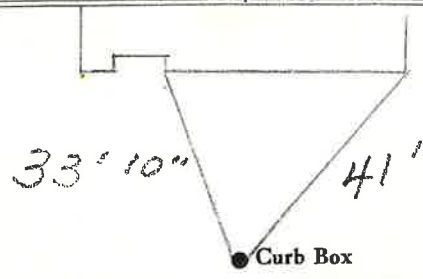

6" Main Elev. of Main at tap 5'

Gate at • • Gate at

• Curb Box