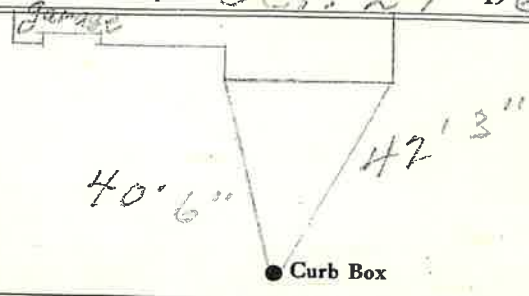


LABOR AND MATERIALS

1" Copper } Connection ^{3/4"} \$ _____
 Lead }
 1 Curb } Cock } ^{3/4} in. \$ _____
 } Valve }
 } T.S. & V. }
 1 Service box { Short 3 1/2 x 4 1/2 }
 Old returned { Long 4 1/2 x 5 1/2 }
 { Buff or Rdway } \$ _____
 25 ³/₄ Ft. in. { Copper } Pipe at \$ _____
 { G.I. }
 { G.I. }
 Nipples _____ in. at \$ _____
 Bushings _____ to _____ in. at \$ _____
 Red'g }
 Inc'g } Coupl'gs _____ to _____ in. at \$ _____
 Union _____ in. at \$ _____
 Meter _____ in. at \$ _____
 Lead Joints at \$ _____
 Compound Joints at \$ _____
 Maintenance Foreman \$ _____
 Hrs. Water Maint. Man-1 at \$ _____
 Hrs. Water Maint. Man-2 at \$ _____
 Hrs. Garage Foreman _____ at \$ _____
 Hrs. Labor _____ at \$ _____
 Hrs. Compressor at \$ _____
 Compensation Ins. at \$ _____ per C \$ _____
 Trucking \$ _____
 Pav't Patch \$ _____
 Tap by Gissard & Co \$ _____
 10-24-60 \$ _____
 \$ _____
 \$ _____
 O'head \$ _____
 \$ _____

St. _____
 Pl. _____
 Ave. No. 19
Halsey
 Name of Owner Albert Ruxio.
 Labor and Mat'l. Report Oct. 24 1960


6" Main Elev. of Main at tap 4 1/2'
 Gate at ● ● Gate at
 ● Curb Box
 ● Curb Box

LSM-5C-2.5 66