

Labor and Materials


Copper } Connection	\$ 2.60
Lead } Connection	
Curb } Cock	
Valve } T.S. & V.	\$ 2.30
Service Box } Short 3/4x1/2	
Old returned } Long 1/2x5/8	\$ 1.40
	Buff. or Rdway	
20 Ft. } in. } Copper	
	Cast iron	\$ 5.20
Nipples	\$
Bushings	\$
Red'g } Couplings	\$
Inc'g } Couplings	\$
Union	\$
Meter	\$
Lbs. Br. Stone	\$
Lbs. Sand	\$
Bags Cement	\$
Paving Brick } Mack	\$
Asphalt } at	\$
Lead Joints	\$
Leadite Joints	\$
6 Hrs. Foreman	\$ 3.75
12 Hrs. Common Labor	\$ 4.88
Hrs. Common Labor	\$
Hrs. Mason	\$
Hrs. Mason's Helper	\$
Hrs. Compressor	\$
Compensation Ins.	\$.23
Trucking	\$ 1.00
Builders' Use of Water	Patch	\$ 5.00
Total		\$ 26.46

79-201

Labor and Material Report

12 1927

19 Harlem St

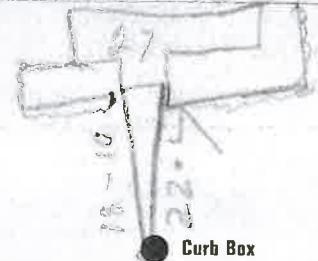

4" Gal Main

Elev of Main at tap 6

Gate at ●

● Gate at

● Curb Box

old tap disconnected
Top on Union St