
1
Labor and Materials
Copper   Connection
Lend Connection
Old returned Short 3%x414 Old returned Buff, or Rdway
Old returned Buff. or Rdway
Ft. Ft. in. Galv Iron Pipe at
(Gast fron ) 
Bushingstoin. at
Red'g Couplingstoin. at\$
Union
Lbs. Br. Stone at.
Lbs. Sand at
Bags Cement 'at\$
Paving Brick { Mack Red Asphalt } at
Lead Joints at
Hrs. Common Labor nto Tappin \$ 50
1.4. Hrs. Common Labor at
Hrs Mason at
Hrs Mason's Helper at
Hrs. Compressor at\$
-1-7
Total \$.26.2

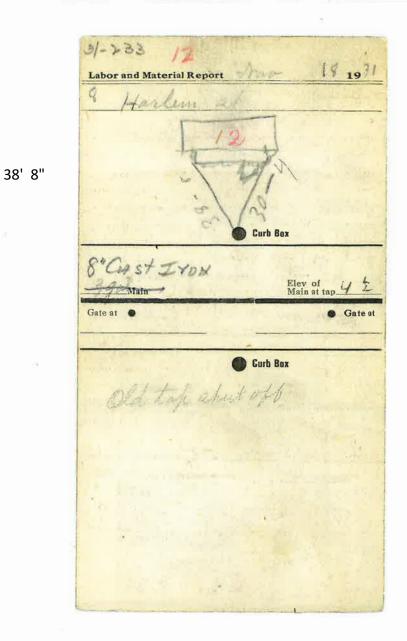

Old tap shut off