


Labor and Materials

1	Copper	Connection	\$ 1.75
1	Curb	{ Cock Valve T.S.&V. } in	\$ 1.70
1	Service Box	{ Short 3 1/2 x 4 1/2 Long 4 1/2 x 5 1/2 } Old returned	\$ 1.45
19	Ft. 3/4 in.	{ Copper Galv. Iron Cast Iron } Pipe at 13 1/2	\$ 2.57
	Nipples in. at	\$
	Bushings to in. at	\$
	Red'g Inc'g	{ Couplings to in. at	\$
	Union in. at	\$
	Meter in. at	\$
	Lbs. Br. Stone	at	\$
	Lbs. Sand	at	\$
	Bags Cement	at	\$
	Paving Brick	{ Mack Red Asphalt } at	\$
	Lead Joints	at	\$
	Leadite Joints	at	\$
2	Hrs. Foreman	at	6.71	\$ 1.38
16	Hrs. Common Labor	at	.45	\$ 7.20
	Hrs. Common Labor	at	\$
	Hrs. Mason	at	\$
	Hrs. Masons Helper	at	\$
	Hrs. Compressor	at	\$
	Compensation Ins	\$ 1.39
	Trucking	\$ 1.00
	Builders Use of Water	Patch	\$ 5.00
Total				\$ 22.39

10 *Harker St*

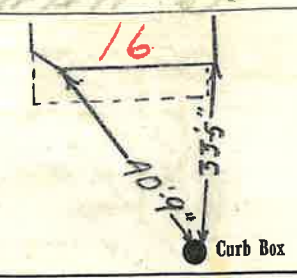

6 Main Elev. of Main at tap 5

Gate at ● ● Gate at

● Curb Box

W