

Labor and Materials

1	Copper	Lead	Connection	3/4		\$ 2.60
1	Curb	Cock Valve	T. S. & V.	2 1/2	in.	\$ 2.30
1	Service Box	Old returned	Short 3/4 x 1 1/2 Long 1 1/2 x 2 1/2 Buff. or Rdway			\$ 1.40
8	Ft.	3/4	Copper Cast Iron	Pipe at		\$ 2.12
	Nipples		in. at			\$
	Bushings		to	in. at		\$
	Red'g Inc'g	Couplings		to	in. at	\$
	Union		in. at			\$
	Meter		in. at			\$
	Lbs. Br. Stone	at				\$
	Lbs. Sand	at				\$
	Bags Cement	at				\$
	Paving Brick	Mack Red Asphalt	at			\$
	Lead Joints	at				\$
	Leadite Joints	at				\$
2	Hrs. Foreman	at				\$ 1.25
8	Hrs. Common Labor	at				\$ 3.25
	Hrs. Common Labor	at				\$
	Hrs. Mason	at				\$
	Hrs. Mason's Helper	at				\$
	Hrs. Compressor	at				\$
	Compensation Ins					\$ 1.2
	Trucking					\$ 1.00
	Builders' Use of Water	Patch				\$ 5.00
Total \$						19.04


29-33

Labor and Material Report

Pi 22

23
1929

15 Main

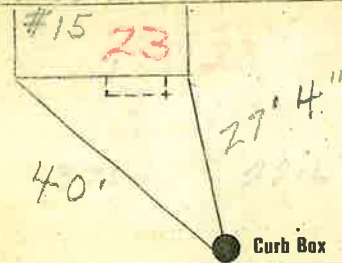

6 Main

Elev of Main at tap 5-

Gate at ●

● Gate at

● Curb Box

old tap shut off