

Labor and Materials


1	Copper	Connection	3/4	\$	2.60
	Lead				
1	Curb	Cock Valve	3/4 in.	\$	2.30
		F.S. & V.			
1	Service Box	Short 3/4x4 1/2		\$	1.40
	Old returned	Long 1 1/2x5 1/2			
		Buff. or Rdway			
9	Ft.	Copper		\$	2.39
	3/4	Galv. Iron	Pipe at		
		Cast Iron			
	Nipples	in. at		\$	
	Bushings	to in. at		\$	
	Red'g	Couplings	to in. at	\$	
	Inc'g				
	Union	in. at		\$	
	Meter	in. at		\$	
	Lbs. Br. Stone	at		\$	
	Lbs. Sand	at		\$	
	Bags Cement	at		\$	
	Paving Brick	Mack	at	\$	
		Red			
		Asphalt			
	Lead Joints	at		\$	
	Leadite Joints	at		\$	
4	Hrs. Foreman	at		\$	2.50
12	Hrs. Common Labor	at		\$	4.88
	Hrs. Common Labor	at		\$	
	Hrs. Mason	at		\$	
	Hrs. Mason's Helper	at		\$	
	Hrs. Compressor	at		\$	
	Compensation Ins.			\$	20
	Trucking			\$	1.00
	Builders' Use of Water	Patch		\$	5.00
				Total \$	22.27

29-18

Labor and Material Report

1909

17 Harbor St

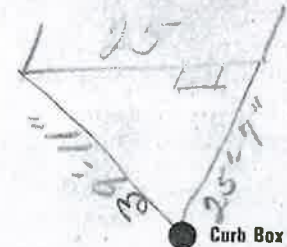

6 Main

Elev of Main at tap 5-

Gate at ●

● Gate at

● Curb Box