

Labor and Materials


Copper	Lead	Connection.....	\$ 1.25	
..	..	Curb { Cock Valve U.S.&V. } ..in	\$ 1.70	
..	..	Service Box Old returned { Short 3 1/2 x 1 1/2 Long 4 1/2 x 5 1/2 } ..	\$ 1.45	
..	9 Ft. 3/4 in.	{ Copper Galv. Iron Cast Iron } Pipe at 13 1/2	\$ 1.22	
..	..	Nipples ..in. at	\$	
..	..	Bushings ..to ..in. at	\$	
..	..	Red'g Inc'g } Couplings.....to.....in.at	\$	
..	..	Union.....in. at	\$	
..	..	Meter.....in. at	\$	
..	..	Lbs. Br. Stone at	\$	
..	..	Lbs. Sand at	\$	
..	..	Bags Cement at	\$	
..	..	Paving Brick { Mack Red Asphalt } at	\$	
..	..	Lead Joints at	\$	
..	..	Leadite Joints at	\$	
..	3	Hrs. Foreman at 6 1/2	\$ 1.88	
..	6	Hrs. Common Labor at 4.5	\$ 3.60	
..	..	Hrs. Common Labor at	\$	
..	..	Hrs. Mason at	\$	
..	..	Hrs. Masons Helper at	\$	
..	..	Hrs. Compressor at	\$	
..	..	Compensation Ins	\$.21	
..	..	Trucking	\$ 1.-	
..	..	Builders Use of Water Patch	\$ 5.-	

Total \$17.31

1935-66

Labor and Material Report June 25 1935

15 Harrison Ave

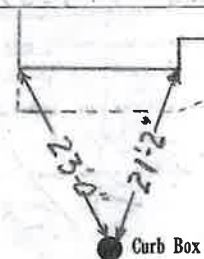

4 Main

Elev. of Main at tap 5 1/2

Gate at ●

● Gate at

● Curb Box

Old tap shut off at main