

Labor and Materials


1	Copper	Connection	3	\$ 2.60
1	Curb	Cock Valve	4	\$ 2.27
1	Service Box	Short 3/4x1/2		\$ 1.38
	Old returned	Long 1/2x5/8		
		Butt or Rdway		
10	Ft.	3/4 in.		\$ 1.80
	Nipples	in. at		\$
	Bushings	to in. at		\$
	Red'g Inc'r	Couplings	to in. at	\$
	Union	in. at		\$
	Meter	in. at		\$
	Lbs. Br. Stone	at		\$
	Lbs. Sand	at		\$
	Bags Cement	at		\$
	Paving Brick	Mack Red Asphalt	at	\$
	Lead Joints	at		\$
	Leadite Joints	at		\$
3	Hrs. Foreman	at		\$ 1.88
1.0	Hrs. Common Labor	at		\$ 4.50
	Hrs. Common Labor	at		\$
	Hrs. Mason	at		\$
	Hrs. Mason's Helper	at		\$
	Hrs. Compressor	at		\$
	Compensation Ins			\$ 2.00
	Trucking			\$ 1.00
	Builders' Use of Water	Patch		\$ 5.00
Total				\$ 70.63

51-17
Labor and Material Report

Page 20 19 21

19

Harrison Ave.

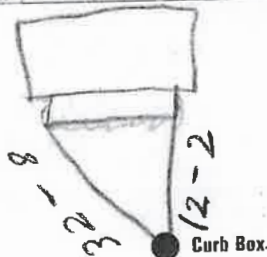

TAX ID # 302.20-1-2

4 Main

Elev of Main at tap 5

Gate at ●

● Gate at

● Curb Box

Old tap disconnected