

Labor and Materials


1	Copper	Connection	3/4"	\$	96
1	Lead				
1	Curb	Cock Valve T.S.&V.	3/4" in	\$	1.33
1	Service Box	Short	3 1/2 x 4 1/2	\$	1.35
	Old returned	Long	4 1/2 x 5 1/2		
		Buff. or Rdway			
8	Ft.	Copper Galv. Iron Cast Iron	Pipe at	15	1.70
	Nipples		in. at	\$	
	Bushings		to in. at	\$	
	Red'g Inc'g	Couplings	to in. at	\$	
	Union		in. at	\$	
	Meter		in. at	\$	
	Lbs. Br. Stone		at	\$	
	Lbs. Sand		at	\$	
	Bags Cement		at	\$	
	Paving Brick	Mack Red Asphalt	at	\$	
	Lead Joints		at	\$	
	Leadite Joints		at	\$	
	Hrs. Foreman		at	\$	
	Hrs. Common Labor		at	\$	
	Hrs. Common Labor		at	\$	
	Hrs. Mason		at	\$	
	Hrs. Masons Helper		at	\$	
	Hrs. Compressor		at	\$	
	Compensation Ins			\$	
	Trucking			\$	
	Builders Use of Water	no patch		\$	
	Total \$				

118

Labor and Material Report Nov 28

1936

21 Harrison Ave 3/4 tap

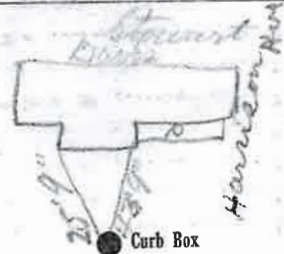

Main Elev. of Main at tap 5'

Gate at ● Gate at ●

Old tap shut off ● Curb Box

TAX ID # 302.20-1-1

[Handwritten signature]