


Labor and Materials

Copper	Connection	7	\$ 2.60
Curb	Cock Valve T.S. & V.	4	\$ 2.30
		3	
Service Box	Short $3\frac{1}{2} \times 4\frac{1}{2}$		\$ 1.40
Old returned	Long 12×30		
	Built on Rdway		
Pt.	Copper Pipe at	3	\$ 1.82
	Cast Iron	4	
Nipples	in. at		\$
Bushings	to in. at		\$
Red'g Inc'g	Couplings to in. at		\$
Union	in. at		\$
Meter	in. at		\$
Lbs. Br. Stone	at		\$
Lbs. Sand	at		\$
Bags Cement	at		\$
Paving Brick	Mack Red Asphalt	at	\$
			\$
			\$
Lead Joints	at		\$
Leadite Joints	at		\$
3 Hrs. Foreman	at		\$ 1.88
7 Hrs. Common Labor	at		\$ 3.25
Hrs. Common Labor	at		\$
Hrs. Mason	at		\$
Hrs. Mason's Helper	at		\$
Hrs. Compressor	at		\$
Compensation Ins			\$ 1.14
Trucking			\$ 1.00
Builders' Use of Water	Patch		\$ 5.00
Total			\$ 19.39

29-15

Labor and Material Report *Api* 3 1929

23 Harrison Ave

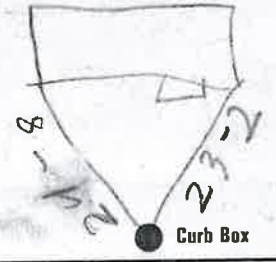

4 Main Elev of Main at tap
 Gate at ● Gate at ●

● Curb Box

*old Tap lead off
 Hole in Street to
 Repaired*