


Labor and Materials

1	Copper } Connection	3		\$ 3.20
1	Curb } Cock Valve } T.S. & V- }	in. 3		\$ 1.00
1	Service Box } Short 3 1/2 x 4 1/2 } Old returned } 3 1/2 x 5 1/2 } } Redway }	1	3	\$ 1.30
7	Ft. 3/4" in. } Copper } } Curb Iron }		Pipe at	\$ 1.74
	Nipples.....	in. at		\$
	Bushings.....	to..... in. at		\$
	Red'g } Couplings	to..... in. at		\$
	Inc'g }			
	Union.....	in. at		\$
	Meter.....	in. at		\$
	Lbs. Br. Stone at			\$
	Lbs. Sand at			\$
	Bags Cement at			\$
	Paving Brick } Mack } } Red } } Asphalt }	at		\$
	Lead Joints at			\$
	Leadite Joints at			\$
2	Hrs. Foreman at	6.25		\$ 1.25
7	Hrs. Common Labor at	4.00		\$ 2.80
	Hrs. Common Labor at			\$
	Hrs. Mason at			\$
	Hrs. Mason's Helper at			\$
	Hrs. Compressor at			\$
1	Compensation Ins.			\$ 1.00
40.5	Trucking			\$ 1.00
10.0	Builders' Use of Water			\$
Total \$				11.83

27-14

Labor and Material Report *Apr 14 1927*

27 Harrison Ave.

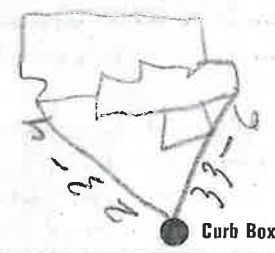

4 Main Elev. of Main at tap 45

Gate at ● ● Gate at

● Curb Box

Old shut off