

LABOR AND MATERIALS

1	Copper	{ Connection	$\frac{3}{4}$	\$	2.29
1	Lead	{			
		{ Cock	$\frac{3}{4}$	\$	2.70
		{ Valve	in.		
		{ L.S. & V.			
1	Service box	{ Short $3\frac{1}{2} \times 4\frac{1}{2}$		\$	4.25
	Old returned	{ Long $4\frac{1}{2} \times 5\frac{1}{2}$			
		{ Buff or Rdway			
27	Ft. $\frac{3}{4}$ in.	{ Copper	Pipe at	35	\$ 9.45
		{ G.I.			
		{ G.I.			
	Nipples	in. at		\$	
	Bushings	to in. at		\$	
	Red'g	{ Coupl'gs to in. at		\$	
	Inc'g	{			
	Union	in. at		\$	
	Meter	in. at		\$	
	Lead Joints at			\$	
	Compound Joints at			\$	
	Hrs. Water Maint. Man-1 at			\$	
3	Hrs. Water Maint. Man-2 at	1.02	\$	3.06	
14	Hrs. Labor at	91	\$	12.74	
	Hrs. Labor at		\$		
	Hrs. Compressor at		\$		
	Compensation Ins. at \$	per C.	\$	35	
	Trucking		\$	1.-	
	Pav't Patch	B.P.	\$		
	Tap by Magnolia		\$		
			\$		
			\$		
	O'head		\$		
			\$	35.84	

Harrison


St.
Pl.
Ave. No. 30

Name of Owner

Rose

Labor and Mat'l. Report

June 16 1950

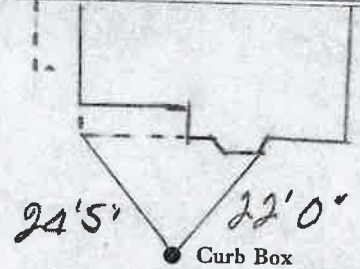

4 Main

Elev. of Main at tap 5

Gate at ●

● Gate at

● Curb Box

To be Billed