

Labor and Materials


1	Copper } Connection $\frac{3}{4}$	\$ 3.20
1	Curb { Cock Valve } $\frac{3}{4}$ in.	\$ 1.00
1	Service Box } Short 4 x 4 Old returned } Long 4 1/2 x 5 Buff. or Rdway }	\$ 1.40
32	Ft. $\frac{3}{4}$ in. } Copper Galv. Iron } Pipe at Cast Iron }	\$ 7.04
1	Nipples $\frac{3}{4}$ in. at	\$ 12
	Bushings..... to..... in. at	\$
1	Reg. } Couplings $\frac{3}{4}$ in. at	\$ 1.5
	Union..... in. at	\$
	Meter..... in. at	\$
	Lbs. Br. Stone at	\$
	Lbs. Sand at	\$
	Bags Cement at	\$
	Paving Brick { Mack Red } at	\$
	Asphalt }	\$
	Lead Joints at	\$
	Leadite Joints at	\$
12	Hrs. Foreman at 62.5	\$ 7.50
17	Hrs. Common Labor at 50	\$ 8.50
11	Hrs. Common Labor at 35	\$ 4.46
	Hrs. Mason at	\$
	Hrs. Mason's Helper at	\$
	Hrs. Compressor at	\$
	Compensation Ins.	\$ 54
	Trucking	\$ 1.00
	Builders' Use of Water	\$
Total		\$ 34.96

26-108

Labor and Material Report

19 26

26-36 1/2 Harrison Ave

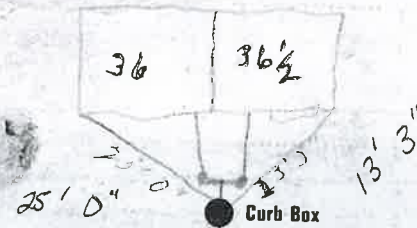

Main

Elev. of Main at tap

TAX ID # 302.19-20-9

Gate at

Curb Box