


Labor and Materials

1	Lead Connection		\$
1	Curb Cock		\$
1	Service Box	(Short 3 1/2 x 4 1/2)	\$
1	Old returned	(Buffalo)	\$
10	Ft. 3/4	in. G. I. Pipe at	\$
	Nipples	in. at	\$
1	Bushings 3/4	to 2/3 in. at	\$
	Red'g Coup	to in. at	\$
	Ine'g Coup	to in. at	\$
	Union	in. at	\$
	Meter	in. at	\$
	Cu. Yds. Br. Stone	at	\$
	Cu. Yds. Sand	at	\$
	Bags Cement	at	\$
	Paving Brick	{ Mack Red Asphalt } at	\$
2	Hrs. Foreman	at	\$
8	Hrs. Common Labor	at	\$
	Hrs. Mason	at	\$
	Hrs.	at	\$
	Hrs.	at	\$
2	Builders' Use of Water	at	\$
		at	\$
	Truck 100	at	\$
		at	\$
		at	\$
		at	\$
	Total		\$ 17.07

June 12
 Labor and Material Report **12** 1925

41 Harrison Ave

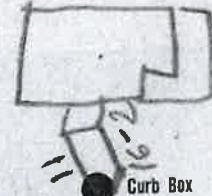

Curb Box

GRANDAL ST

10 Main Elev. of Main at tap *4*

Gate at ● Gate at ●

● Curb Box

Measured in off from Grandal St.