


LABOR AND MATERIALS

1 Copper } Connection 3/4" \$
~~1~~ Curb } Cock } 3/4 in. DRISDAI \$
~~1~~ Service box } ~~Long 4 1/2 x 5 1/2~~ } \$
 Old returned } ~~Long 4 1/2 x 5 1/2~~ } \$
 7 3/4 in. } { Copper } Pipe at \$
 } { G. I. }
 } { C. I. }
 Nipples in. at \$
 Bushings to in. at \$
 Red'g }
 Inc'g } Coupl'gs to in. at \$
 Union in. at \$
 Meter in. at \$
 Lead Joints at \$
 Compound Joints at \$
 Maintenance Foreman \$
 Hrs. Water Maint. Man-1 at \$
 Hrs. Water Maint. Man-2 at \$
 Hrs. Garage Foreman at \$
 Hrs. Labor at \$
 Hrs. Compressor at \$
 Compensation Ins. at \$ per C \$
 Trucking \$
 Pav't Patch \$
TAP MADE BY GIFFORD & CO \$
July-10-1975 \$
 O'head \$
 \$

HARRISON Sec. No. 45
 Ave. No.

Name of Owner
Rodger Corkins

Labor and Mat'l. Report July 10 1975

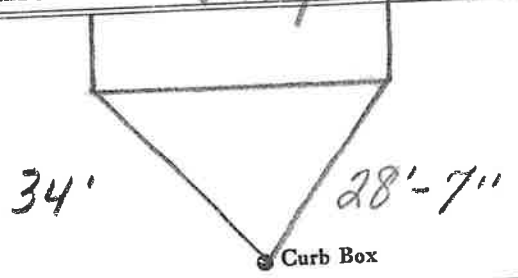

4" Main Elev. of Main at tap 5 1/2'
 Gate at • Gate at •

✓
 • Curb Box
old TAP DISCONNECTED AT MAIN