

LABOR AND MATERIALS


1	Copper Lead	{ Connection	3/4			\$ 3.79
1	Curb	{ Cock Valve T. S. & V.	3/4 in.			\$ 2.70
	Service Box	{ Short 3/2x4 1/2 Long 4/2x5 1/2 Buff. or Rdway				\$ 4.25
	Old returned					
8	Ft. 3/4 in.	{ Copper Galv Iron Cast Iron	Pipe at	35		\$ 2.80
	Nipples	in. at				\$
	Bushings	to in. at				\$
	Red'g Inc'g	{ Couplings	to in. at			\$
	Union	in. at				\$
	Meter	in. at				\$
	Lead Joints at					\$
	Leadite Joints at					\$
4	Hrs. Foreman at	W.M.M. - 1.12				\$ 4.48
5	Hrs. Chauffeur at	2.10				\$ 5.10
	Hrs. Tapper at					\$
20	Hrs. Labor at	91				\$ 18.20
	Hrs. Labor at					\$
	Hrs. Compressor at					\$
	Compensation Ins.					\$ 1.62
	Trucking					\$
	Builders Use of Water	B.P.				\$
	lap by Miller					\$
						\$
						\$
						\$
						\$
						\$ 41.44

1st-1930

St. _____
Pt. _____
Ave. No. 47

Name of Owner
Robert O Connor

Labor and Mat'l. Report June 21 1950

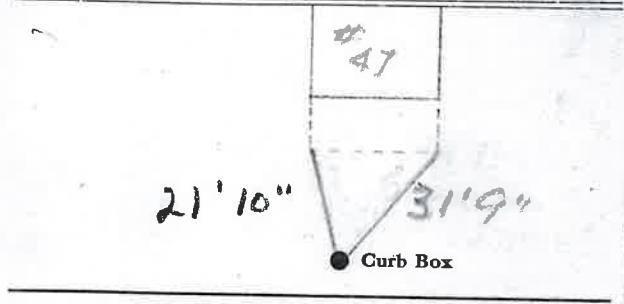

4 Main Elev. of Main at tap 41

Gate at ● ● Gate at

● Curb Box

15 to Billed