

LABOR AND MATERIALS

1	Copper	Connection	3/4	\$	2.87	
1	Lead					
1	Curb	Cock Valve	3/4 in.	\$	3.62	
						T.S. & V.
	Service box	Short 3 1/2 x 4 1/2	Same	\$	—	
	Old returned					Long 4 1/2 x 5 1/2
35	Ft. 3/4 in.	Copper	Pipe at 32	\$	11.20	
4						G.I.
						C.I.
	Nipples	in. at		\$		
	Bushings	to in. at		\$		
	Red'g Inc'g	Coupl'gs	to in. at	\$		
	Union					in. at
	Meter	in. at		\$		
	Lead Joints at			\$		
	Compound Joints at			\$		
6	Hrs. Water Maint. Man—1 at	1.12		\$	6.72	
6	Hrs. Water Maint. Man—2 at	1.02		\$	6.12	
22	Hrs. Labor— at	91		\$	20.02	
	Hrs. Labor— at			\$		
4	Hrs. Compressor at	1.20		\$	4.80	
	Compensation Ins. at \$ 2.18 per C.			\$.72	
	Trucking			\$	2.00	
	Pav't Patch			\$	14.85	
	Truck by Miller			\$		
	O'head			\$		
				\$	72.92	

HARRISON


St
Pt
Ave. No. 50

Name of Owner

Levin

Labor and Mat'l. Report

Nov 28 1949

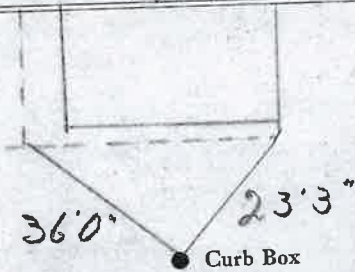

4 Main Elev. of Main at tap 4'2"

Gate at • Gate at •

• Curb Box

Philip Levin
#330 Garfield
to be billed