

Labor and Materials


1	Copper	Connection	\$	2.60
1	Curb	Cock Valve T.S. & V. in.	\$	2.27
1	Service Box	Short 3/4 x 1/2	\$	1.38
	Old returned	Long 1/2 x 5/8		
		Buff. or Rdway		
10	Ft.	Copper Galv. Iron Pipe at Cast Iron in.	\$	1.80
	Nipples in. at	\$	
1	Bushings to in. at	\$	1.0
	Red'g Inc'g	Couplings to in. at	\$	
	Union in. at	\$	
	Meter in. at	\$	
	Lbs. Br. Stone	at	\$	
	Lbs. Sand	at	\$	
	Bags Cement	at	\$	
	Paving Brick	Mack Red Asphalt at	\$	
	Lead Joints	at	\$	
	Leadite Joints	at	\$	
3/4	Hrs. Foreman	at	\$	47
3/4	Hrs. Common Labor	at <i>Tapper</i>	\$	38
1 1/2	Hrs. Common Labor	at	\$	2.93
	Hrs. Mason	at	\$	
	Hrs. Mason's Helper	at	\$	
	Hrs. Compressor	at	\$	
	Compensation Ins	\$.12
	Trucking	\$	1.00
	Builders' Use of Water	\$	
				Total \$	13.05

31-200

Labor and Material Report

4-25-1931

57 Harrison Ave

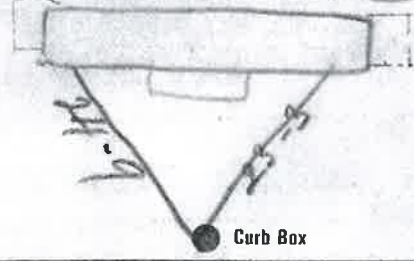

6 Main *Tap on Street* Elev of Main at tap *2*

Gate at ● "Gate at ●

● Curb Box

Old tap die

H.E. Co