


LABOR AND MATERIALS

1	Copper	} Connection	3/4"	\$	2.08
	Lead				
1	Curb	} Valve	3/4 in.	\$	3.89
		T.S. & V.			
1	Service box	} Short 3 1/2 x 4 1/2		\$	4.32
	Old returned				
		Long 4 1/2 x 5 1/2			
		Buff or Rdway			
27	Ft. 3/4 in.	} Copper	Pipe at	\$	12.15
		C.I.			
		C.I.			
	Nipples	in. at		\$	
	Bushings	to in. at		\$	
	Red'g	} Coupl'gs	to in. at	\$	
	Inc'g				
	Union	in. at		\$	
	Meter	in. at		\$	
	Lead Joints	at		\$	
	Compound Joints	at		\$	
	Maintenance Foreman			\$	
	Hrs. Water Maint. Man-1	at		\$	
7	Hrs. Water Maint. Man-2	at 1.613		\$	11.29
	Hrs. Garage Foreman	at		\$	
7	Hrs. Labor	at 1.30		\$	9.10
	Hrs. Compressor	at		\$	
	Compensation Ins. at	5.686 per C		\$	1.16
	Trucking			\$	1.50
	Pay't Patch			\$	
	Tap by Gifford 4-13-56			\$	
				\$	
				\$	
	O'head			\$	
				\$	46.49

Harrison (Ext.) Ave. No. 65

Name of Owner
Winer (Jones)

Labor and Mat'l. Report April 13 1956

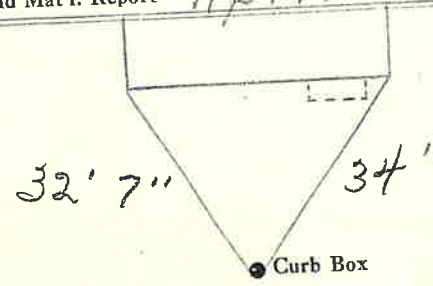

6" Main Elev. of Main at tap 5'

Gate at • Gate at •

• Curb Box