


LABOR AND MATERIALS

1	Copper Lead	Connection	\$
1	Curb	Cock Valve T.S. & V. } in.	\$
1	Service box	Short 3 1/2 x 4 1/2	\$
	Old returned	Long 4 1/2 x 5 1/2	
11	Ft. 3/4 in.	Copper G.I. C.I. } Pipe at	\$
	Nipples	in. at	\$
	Bushings	to in. at	\$
	Red'g	} Coupl'gs. to in. at	\$
	Inc'g		
	Union	in. at	\$
	Meter	in. at	\$
	Lead Joints	at	\$
	Compound Joints	at	\$
	Maintenance Foreman		\$
	Hrs. Water Maint. Man-1	at	\$
	Hrs. Water Maint. Man-2	at	\$
	Hrs. Garage Foreman	at	\$
	Hrs. Labor	at	\$
	Hrs. Compressor	at	\$
	Compensation Ins.	at \$ per C	\$
	Trucking		\$
	Pay't Patch		\$
	Tap by Jiggard & Co.		\$
	6-25-56		\$
	O'head		\$
			\$

Harrison St. Pl. Ave. No. 66
 Name of Owner

Jones

Labor and Mat'l. Report June 25 19 56

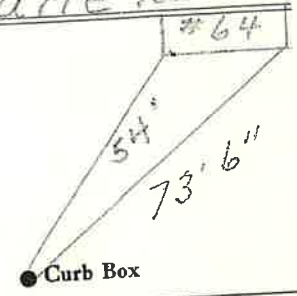

6" Main Elev. of Main at tap 5"
 Gate at • Gate at •

• Curb Box

Measured from
 South Side #64.
 Lot Top.