

LABOR AND MATERIALS


1	Copper Lead	Connection	3/4"	\$	2.71
1	Curb	Cock Valve T.S. & V.	3/4" in.	\$	3.83
1	Service box Old returned	Short 3 1/2 x 4 1/2 Long 4 1/2 x 5 1/2 Buff or Rdway		\$	4.69
27	Ft.	3/4" in. Copper G.I. } Pipe at	45	\$	12.15
	Nipples	in. at		\$	
	Bushings	to in. at		\$	
	Red'g Inc'g	Coupl'gs to in. at		\$	
	Union	in. at		\$	
	Meter	in. at		\$	
	Lead Joints	at		\$	
	Compound Joints	at		\$	
	Maintenance Foreman			\$	
	Hrs. Water Maint. Man-1	at		\$	
2	Hrs. Water Maint. Man-2	at	1.24	\$	2.48
	Hrs. Garage Foreman	at		\$	
4	Hrs. Labor	at	1.13	\$	4.52
	Hrs. Compressor	at		\$	
	Compensation Ins.	at \$ 4.29 per C.		\$	30
	Trucking			\$	1.50
	Pav't Patch			\$	
	Tap by Giffard	6-2455		\$	
	O'head			\$	
				\$	32.18

32.18

Harrison Ext. Ave. No. 69

Name of Owner
Ed. LaRose

Labor and Mat'l. Report
JUNE 24 1955

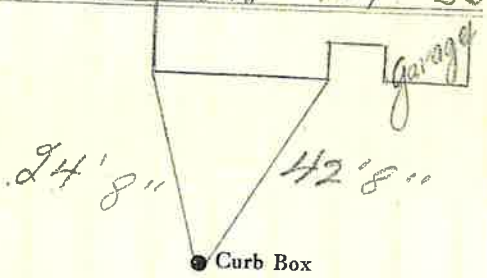

6" Main Elev. of Main at tap 6'
Gate at • Gate at •

• Curb Box