


LABOR AND MATERIALS

1	Copper Lead	Connection	3/4"	\$
1	Curb	Cock Valve T.S. & V.	3/4" in.	\$
1	Service box	Short 3 1/2 x 4 1/2		
	Old returned	Long 4 1/2 x 5 1/2		
		Buff or Rdway		\$
27	Ft.	3/4 in.	{ Copper } Pipe at	\$
			{ G. I. }	
			{ G. I. }	
	Nipples	in. at		\$
	Bushings	to in. at		\$
	Red'g } Coupl'gs	to in. at		\$
	Inc'g }			
	Union	in. at		\$
	Meter	in. at		\$
	Lead Joints at			\$
	Compound Joints at			\$
	Maintenance Foreman			\$
	Hrs. Water Maint. Man	1 at		\$
	Hrs. Water Maint. Man	2 at		\$
	Hrs. Garage Foreman	at		\$
	Hrs. Labor	at		\$
	Hrs. Compressor at			\$
	Compensation Ins. at \$	per C		\$
	Trucking			\$
	Pav't Patch			\$
	Tap by Gifford			\$
	Tap Co.			\$
		12-6-62		\$
	O'head			\$

St. Pl. Ave. No. 8

Name of Owner
Drs. Simmon + Reid

Labor and Mat'l. Report Dec. 12, 19 62

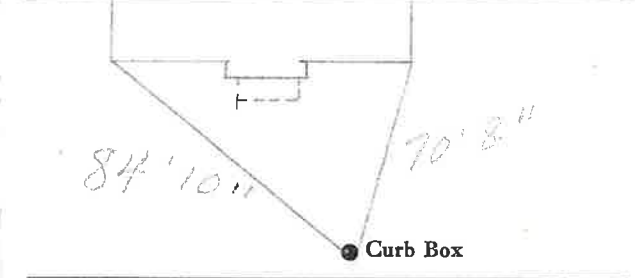

C.I.
Main Elev. of Main at tap 4 1/2'

Gate at ● Gate at ●
● Curb Box