


LABOR AND MATERIALS

1	Copper	} Connection	$\frac{1}{2}'' \times \frac{3}{4}''$	\$
	Lead			
1	Curb	} Cock Valve T. S. & V.	$\frac{3}{4}$ in.	\$
1	Service box			
	Old returned			
			{ Short $3\frac{1}{2} \times 4\frac{1}{2}$ Long $4\frac{1}{2} \times 5\frac{1}{2}$ Buff or Rdway }	\$
14'8"	Ft.	} Pipe at	$\frac{3}{4}$ in.	\$
	Nipples	in. at		\$
	Bushings	to in. at		\$
	Red'g	} Coupl'gs.	to in. at	\$
	Inc'g			
	Union	in. at		\$
	Meter	in. at		\$
	Lead Joints	at		\$
	Compound Joints	at		\$
	Maintenance Foreman			\$
	Hrs. Water Maint. Man	1 at		\$
	Hrs. Water Maint. Man	2 at		\$
	Hrs. Garage Foreman	at		\$
	Hrs. Labor	at		\$
	Hrs. Compressor	at		\$
	Compensation Ins. at \$	per C		\$
	Trucking			\$
	Pav't Patch			\$
	Tap by Gifford & Co.			\$
	6-4-68.			\$
	O'head			\$
				\$

HARRISON St. Pl. Ave. No. 1

Name of Owner
Helen Clark.

Labor and Mat'l. Report June 4 1968

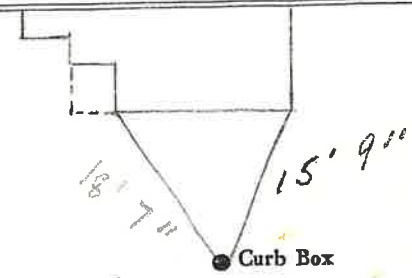

6" Main 1975 Elev. of Main at tap 5'

Gate at • • Gate at

• Curb Box


LABOR AND MATERIALS

Copper	} Connection	_____	\$	
Lead			\$	
Curb	{ Cock Valve } _____ in.		\$	
	{ T.S. & V. }		\$	
Service box	{ Short 3-1/2 x 4-1/2 }		\$	
Old returned	{ Long 4-1/2 x 5-1/2 }		\$	
Ft. _____ in.	{ Copper } Pipe at _____		\$	
	{ G.I. }		\$	
	{ C.I. }		\$	
Nipples	_____ in. at _____		\$	
Bushings	_____ to _____ in. at _____		\$	
Red'g			\$	
Inc'g			\$	
Union	_____ in. at _____		\$	
Meter	_____ in. at _____		\$	
			\$	
Compound Joints	at _____		\$	
Maintenance Foreman			\$	
Hrs. Water Maint. Man - 1	at _____		\$	
Hrs. Water Maint. Man - 2	at _____		\$	
Hrs. Garage Foreman	at _____		\$	
Hrs. Labor	at _____		\$	
Hrs. Compressor	at _____		\$	
			\$	
			\$	
Trucking			\$	
Pav't Patch			\$	
			\$	
			\$	
St. _____
Pl. _____
Ave. No. 1

Name of Owner Harrison Pr.

Labor and Mat'l. Report 10 2016

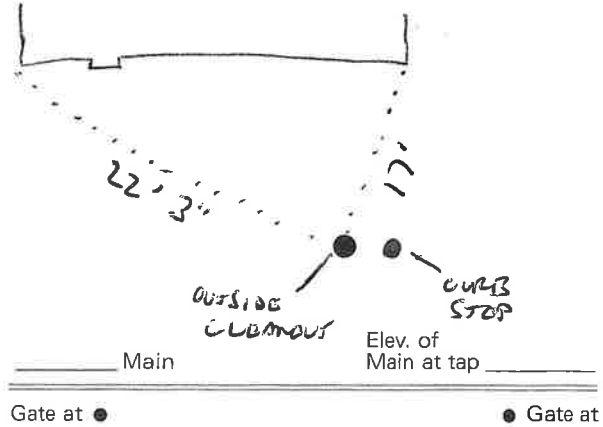

● Gate at ● Gate at

● Curb Box