

LABOR AND MATERIALS

?	Copper	} Connection		\$
1	Lead			
1	Curb	} Cock Valve T.S. & V.	in.	\$
1	Service box		} Short 3 1/2 x 4 1/2 Long 4 1/2 x 5 1/2 Buff or Rdway	
	Old returned			
8	Ft.	} Copper C.I.?	Pipe at	\$
	in.			
	Nipples	in. at		\$
	Bushings	to in. at		\$
	Red'g	} Coupl'gs	to in. at	\$
	Inc'g			
	Union	in. at		\$
	Meter	in. at		\$
	Lead Joints	at		\$
	Compound Joints	at		\$
	Maintenance Foreman			\$
	Hrs. Water Maint. Man-1	at		\$
	Hrs. Water Maint. Man-2	at		\$
	Hrs. Garage Foreman	at		\$
	Hrs. Labor	at		\$
	Hrs. Compressor	at		\$
	Compensation Ins. at \$	per C.		\$
	Trucking			\$
	Pav't Patch			\$
	O'head			\$

7/31/95

Measured in by Miller & Fosmire Oct. 17-56


Harrison

St. Pl. Ave. No. 2

Name of Owner

Measured in Oct. 17-56

Labor and Mat'l. Report

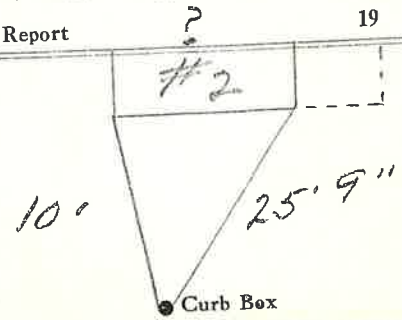

6" Main 1995 Elev. of Main at tap 4 1/2"

Gate at •

• Gate at

• Curb Box
Curb box outside of curb.