

LABOR AND MATERIALS


1	Copper	Connection	3/4" Female Adapter	\$
1	Lead			\$
1	Curb	Cock Valve } 3/4 in.	T.S. & V. }	\$
1	Service box			Short 3 1/2 x 4 1/2
	Old returned	Long 4 1/2 x 5 1/2		\$
		Buff or Rdway		\$
8'3"	3/4 in.	Copper } Pipe at	G.I. }	\$
				G.I. }
1	Nipples	1/2 in. at	12" Brass	\$
1	Bushings	3/4 to 1/2 in. at		\$
	Red'g			\$
	Inc'g	Coupl'gs to in. at		\$
	Union	in. at		\$
	Meter	in. at		\$
	Lead Joints	at		\$
	Compound Joints	at		\$
	Maintenance Foreman			\$
	Hrs. Water Maint. Man-1	at		\$
	Hrs. Water Maint. Man-2	at		\$
	Hrs. Garage Foreman	at		\$
	Hrs. Labor	at		\$
	Hrs. Compressor	at		\$
	Compensation Ins.	at \$ per C		\$
	Trucking			\$
	Pav't Patch			\$
	Tap by Giesseiroff			\$
	9-2-59			\$
	O'head			\$

✓

Harrison St. PL. Ave. No. 4

Name of Owner Ed. Garrow

Labor and Mat'l. Report Sept. 2 19 59

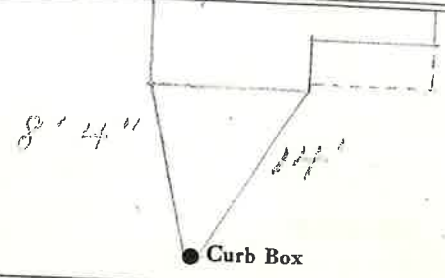

6" Main 1975 Elev. of Main at tap 5"

Gate at • Gate at •

• Curb Box

SEWER CLEAN OUT

9' - LEFT SIDE

11' - RIGHT SIDE