


Same 2" x 2" x 1/2" Tee

Labor and Materials

1	Copper	} 3/4" Female Connection. Adapter	
1	Lead		
1	Curb	} 3/4" in	
	Cock Valve P.S.&V.		
1	Service Box	} Short 3 1/2 x 4 1/2 Long 4 1/2 x 5 1/2	
	Old returned		Buff. or Rawex
10 1/2	3/4" in.	} Copper Galv. Iron Cast Iron	Pipe at
1	Nipples		1/2 in. at
2	Bushings	3/4" to 1/2 in.	at
	Red'g Inc'g	} Couplings	to
	Union	in. at	
	Meter	in. at	
	Lbs. Br. Stone	at	
	Lbs. Sand	at	
	Bags Cement	at	
	Paving Brick	} Mack Red Asphalt	at
	Lead Joints		at
	Leadite Joints	at	
	Hrs. Foreman	at	
	Hrs. Common Labor	at	
	Hrs. Common Labor	at	
	Hrs. Mason	at	
	Hrs. Masons Helper	at	
	Hrs. Compressor	at	
	Compensation Ins		
	Trucking		
	Builders Use of Water		
	Total	\$	

✓  
Labor and Material Report Aug. 11 1960

6 Harrison Place

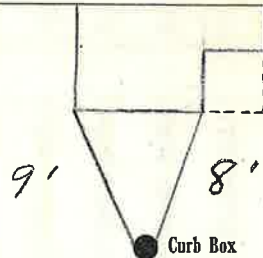

6" Main 1975

Elev of Main at tap 5'

Gate at ●

● Gate at

OWNER ● Curb Box  
G. B. McMurtry