


**Labor and Materials**

.....Lead Connection .....	\$
.....Curb Cock .....	\$
.....Service Box { Short 3 1/2 x 4 1/2 Old returned { Long 4 1/2 x 5 1/2 Buffalo	\$
.....Ft. ....in. G. I. Pipe at.....	\$
.....Nipples.....in. at.....	\$
.....Bushings .....	to.....in. at.....
.....Red'g Coup.....to.....in. at.....	\$
.....Inc'g Coup.....to.....in. at.....	\$
.....Union.....in. at.....	\$
.....Meter.....in. at.....	\$
.....Cu. Yds. Br. Stone at.....	\$
.....Cu. Yds. Sand at.....	\$
.....Bags Cement at.....	\$
.....Paving Brick { Mack Red Asphalt } at.....	\$
.....Hrs. Foreman at .....	\$
.....Hrs. Common Labor at .....	\$
.....Hrs. Mason at .....	\$
.....Hrs.....at.....	\$
.....Hrs.....at.....	\$
.....Builders' Use of Water .....	\$
.....at.....	\$
.....at.....	\$
.....Total \$.....	

Labor and Material Report

Sept. 16 1932

7 Harrison Place

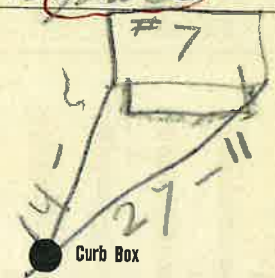

6" Main 1995

Elev. of Main at tap

Gate at ●

● Gate at

● Curb Box

Curb Box  
Measurement,  
Sept 16-32  
By Penon