

LABOR AND MATERIALS


Copper	} Connection		\$	
Lead				
Curb	} Cock Valve	} in.	\$	
				} T. S. & V.
Service box	} Short 3 1/2 x 4 1/2		\$	
Old returned				} Long 4 1/2 x 5 1/2
Ft.	} Copper	} Pipe at	\$	
in.				} G. I.
Nipples	in. at		\$	
Bushings	to	in. at	\$	
Red'g	} Coupl'gs	} to	} in. at	
Inc'g				
Union	in. at		\$	
Meter	in. at		\$	
Lead Joints	at		\$	
Compound Joints	at		\$	
Maintenance Foreman			\$	
Hrs. Water Maint. Man-1	at		\$	
Hrs. Water Maint. Man-2	at		\$	
Hrs. Garage Foreman	at		\$	
Hrs. Labor-	at		\$	
Hrs. Compressor	at		\$	
Compensation Ins. at \$	per C.		\$	
Trucking			\$	
Pav't Patch			\$	
			\$	
			\$	
O'head			\$	
			\$	

Hartford

St. PL. Ave. No. 2

Name of Owner

Measured in Labor and Mat'l. Report April 20 1954

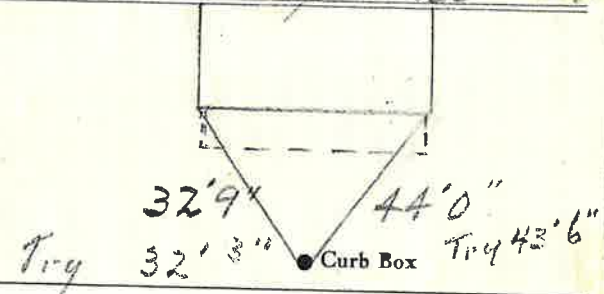

4" Main

Elev. of Main at tap 4 1/2"

Gate at ●

● Gate at

● Curb Box

To shut off Turn to Left, On Turn to Right.