

### LABOR AND MATERIALS


1 Copper	Connection	2	\$ 21.03
1 Lead			
1 Curb	Cock Valve	2 in.	\$ 20.53
	F. S. & V.		
1 Service box	Short 3 1/2 x 4 1/2		
Old returned	Long 4 1/2 x 5 1/2		
	Buff or Rdway		\$ 10.00
34 Ft. 2 in.	Copper	Pipe at 9 1/4"	\$ 31.03
	G.I.		
	C.I.		
Nipples	in. at		\$
Bushings	to in. at		\$
1 Red'g	Coupl'gs 2" to		\$ 97
1 Inc'g			
Union	in. at		\$
Meter	in. at		\$
Lead Joints	at		\$
Compound Joints	at		\$
6 Hrs. Water Maint. Man-1	at 1.12		\$ 67.20
Hrs. Water Maint. Man-2	at		\$
4 Hrs. Labor	at 91		\$ 364
Hrs. Labor	at		\$
Hrs. Compressor	at		\$
Compensation Ins. at \$	per C.		\$ 23
Trucking			\$ 1.00
Pav't Patch			\$
1 Excavator - O'Connor			\$ 12.50
1/2 hr Bull. Apper " 602			\$ 2.00
O'head			\$
			\$
			\$ 109.65

2/5 Tap by Miller

St. Baltimore  
Pl. 1-2  
Ave. No. 1-2

Name of Owner  
Colonial Garden Apts.

Labor and Mat'l. Report June 28 1950

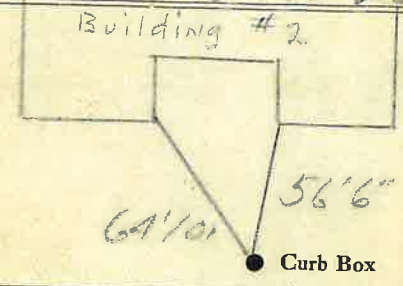

6" Main Elev. of Main at tap 5

Gate at ● Gate at ●

● Curb Box