


LABOR AND MATERIALS

1	Copper	} Connection	3/4"	\$
1	Lead			
1	Curb	} Cock Valve T.S. & V.	3/4 in.	\$
1	Service box		} Short 3 1/2 x 4 1/2	
1	Old returned			Long 4 1/2 x 5 1/2
9	Ft.	} Copper G.I. G.I.	3/4 in.	Pipe at \$
	Nipples		in. at \$	
	Bushings		to in. at \$	
	Red'g	} Coupl'gs	to in. at \$	
	Inc'g			
	Union	in. at \$		
	Meter	in. at \$		
	Lead Joints	at \$		
	Compound Joints	at \$		
	Maintenance Foreman	\$		
	Hrs. Water Maint. Man-1	at \$		
	Hrs. Water Maint. Man-2	at \$		
	Hrs. Garage Foreman	at \$		
	Hrs. Labor	at \$		
	Hrs. Compressor	at \$		
	Compensation Ins. at \$	per C \$		
	Trucking	\$		
	Pav't Patch	\$		
	Tap by Giggard	\$		
	1st Cal. 5-9-60	\$		
	O'head	\$		

Hartford St. Pl. Ave. No. 13

Name of Owner
Ed. Perkett.

Labor and Mat'l. Report May 9 1960

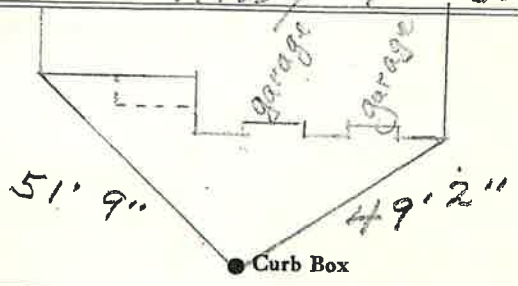

4" Main Elev. of Main at tap 5'

Gate at • Gate at

• Curb Box