

Labor and Materials

1	Lead Connection		\$
1	Curb Cock		\$
1	Service Box	{ Short 3 1/2 x 4 1/2 Old returned Long 4 1/2 x 5 1/2 Buffalo	\$
25	Ft. 3/4 in. G. I. Pipe at	0.40	\$
	Nipples	in. at	\$
	Bushings	to in. at	\$
	Red'g Coup	to in. at	\$
	Inc'g Coup	to in. at	\$
	Union	in. at	\$
	Meter	in. at	\$
	Cu. Yds. Br. Stone at		\$
	Cu. Yds. Sand at		\$
	Bags Cement at		\$
	Paving Brick	{ Mack Red Asphalt } at	\$
2	Hrs. Foreman at		\$
12	Hrs. Common Labor at		\$
	Hrs. Mason at		\$
	Hrs.	at	\$
	Hrs.	at	\$
yes	Builders' Use of Water		\$
	Truck 1.00	at	\$
	MAN HOLES	at	\$
		at	\$
		at	\$
	Total	\$	

Labor and Material Report

1925

347 Tapman & Hartford Ave



Curb Box

4" Main

Elev. of Main at tap 4 1/2

Gate at ●


● Gate at

● Curb Box

X (3) Hartford Ave

4

5/20/02

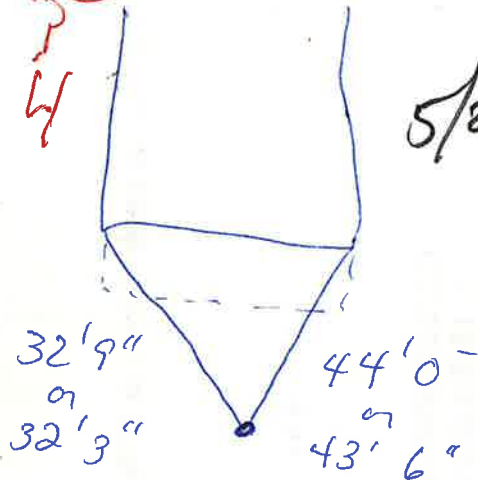

DONE

(CW)