

Labor and Materials

1. Copper } Connection <i>3/4"</i>	\$ 1.75
1. Lead }	
1. Curb { Cock Valve } <i>3/4"</i> in	\$ 1.70
1. Service Box { T.S.&V. }	
Old returned { Short <i>3 1/2 x 1 1/2</i> }	\$ 1.45
{ Long <i>4 1/2 x 6 1/2</i> }	
{ Buff. or Rdway. }	
3.2 Ft. <i>3/4"</i> in. { Copper } Pipe at <i>13/16"</i>	\$ 4.32
{ Galv. Iron }	
{ Cast Iron }	
..... Nipples in. at	\$
..... Bushings to in. at	\$
..... Red'g } Couplings to in. at	\$
..... Inc'g }	
..... Union in. at	\$
..... Meter in. at	\$
..... Lbs. Br. Stone at	\$
..... Lbs. Sand at	\$
..... Bags Cement at	\$
..... Paving Brick { Mack } at	\$
{ Red }	
{ Asphalt }	
..... Lead Joints at	\$
..... Leadite Joints at	\$
8. Hrs. Foreman at <i>6 1/2</i>	\$ 5-
3. Hrs. Common Labor at <i>50</i>	\$ 1.50
15. Hrs. Common Labor at <i>45</i>	\$ 6.75
..... Hrs. Mason at	\$
..... Hrs. Masons Helper at	\$
..... Hrs. Compressor at	\$
..... Compensation Ins	\$.50
..... Trucking	\$ 1-
..... Builders Use of Water Patch	\$ 5-
Total \$ <u>28.47</u>	


1935-86

Labor and Material Report

26

1935

3/4" tap at 6 Hartford Ave

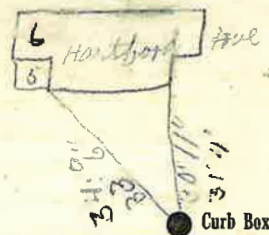

6.7 Main

Elev. of Main at tap *4 1/2*

Gate at ● TAX ID # 303.9-7-24 ● Gate at

● Curb Box

*New tap
Old tap to be shut off on ridge
old tap shut off on
ridge
By J. H. Attmore
Before Paving Tap*