

LABOR AND MATERIALS


Copper	}	Connection	\$			
Lead						
Curb	}	Cock	in.	\$		
		Valve				
		T. S. & V.				
Service box	}	Short 3½ x 4½	\$			
Old returned		Long 4½ x 5½				
		Buff or Rdway				
Ft.	}	Copper	Pipe at	\$		
in.		G. I.				
		G. I.				
Nipples	in.	at	\$			
Bushings	to	in.	\$			
Red'g	}	Coupl'gs	to	in.	at	\$
Inc'g						
Union	in.	at	\$			
Meter	in.	at	\$			
Lead Joints	at		\$			
Compound Joints	at		\$			
Maintenance Foreman			\$			
Hrs. Water Maint. Man	1	at	\$			
Hrs. Water Maint. Man	2	at	\$			
Hrs. Garage Foreman		at	\$			
Hrs. Labor		at	\$			
Hrs. Compressor		at	\$			
Compensation Ins.	at \$	per C	\$			
Trucking			\$			
Pav't Patch			\$			
			\$			
			\$			
			\$			
O'head			\$			
			\$			

St. _____
~~Pt.~~
 Ave. No. 7

Hartford

Name of Owner _____
Harvey

Labor and Mat'l. Report _____ 1986

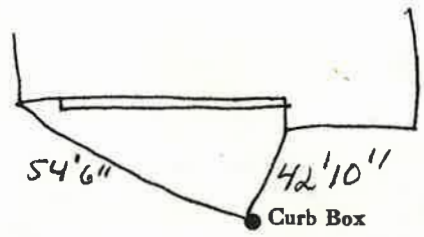

Main Elev. of
Main at tap

Gate at ● ● Gate at

TAX ID # 303.9-6-5

● Curb Box