

LABOR AND MATERIALS


Copper	}	Connection	\$
Lead			
Curb	}	Cock	\$
		Valve	
		T. S. & V.	
Service box	}	Short $3\frac{1}{2} \times 4\frac{1}{2}$	\$
Old returned		Long $4\frac{1}{2} \times 5\frac{1}{2}$	
		Buff or Rdway	
Ft. in.	}	Copper	\$
		G. I.	
		C. I.	
Nipples	in. at	\$	
Bushings	to in. at	\$	
Red'g	}	Coupl'gs to in. at	\$
Union	in. at	\$	
Meter	in. at	\$	
Lead Joints	at	\$	
Compound Joints	at	\$	
Hrs. Water Maint. Man	—1 at	\$	
Hrs. Water Maint. Man	—2 at	\$	
Hrs. Labor	— at	\$	
Hrs. Labor	— at	\$	
Hrs. Compressor	at	\$	
Compensation Ins.	at \$ per C.	\$	
Trucking		\$	
Pav't Patch		\$	
		\$	
		\$	
O'head		\$	
		\$	

St. 8
 Ave. No. 8

Hartford

Name of Owner _____

Labor and Mat'l. Report *May 23* 1950

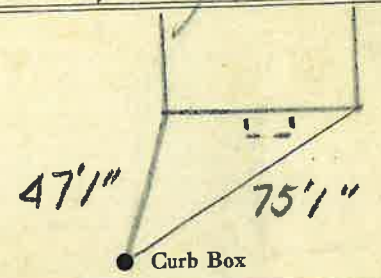

4" Main Elev. of Main at tap 5"

Gate at ● ● Gate at

● Curb Box