


**Labor and Materials**

1	Copper	Connection	\$ 2.70
1	Lead	.....	.....
1	Curb	Cock Valve T.S. & V. in. ....	\$ 2.39
1	Service Box	Short 3 1/2 x 4 1/2	\$ 1.45
	Old returned	Long 4 1/2 x 5 1/2	
35	3/4 P	Copper Galv. Iron Pipe at	9.45
		Cast Iron	
	Nipples	in. at	\$
	Bushings	to in. at	\$
	Red'g Inc'g	Couplings to in. at	\$
	Union	in. at	\$
	Meter	in. at	\$
	Lbs. Br. Stone	at	\$
	Lbs. Sand	at	\$
	Bags Cement	'at	\$
	Paving Brick	Mack Red Asphalt at	\$
	Lead Joints	at	\$
	Leadite Joints	at	\$
	Hrs. Foreman	at	\$
8	Hrs. Common Labor	at	3.60
	Hrs. Common Labor	at	\$
	Hrs. Mason	at	\$
	Hrs. Mason's Helper	at	\$
	Hrs. Compressor	at	\$
	Compensation Ins		\$ 1.11
	Trucking		\$ 1.00
	Builders' Use of Water		\$
Total \$			20.70

**Labor and Material Report**

9-23-1930

Hartman Place # 12

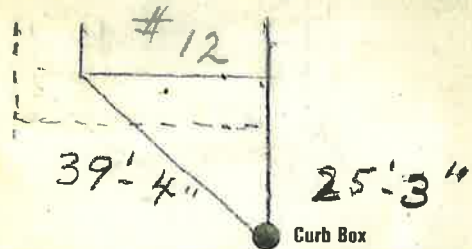

4 Main Elev of Main at tap 5  
 Gate at ● Gate at ●

● Curb Box