

LABOR AND MATERIALS


1	Copper	} Connection	3/4"	\$	
1	Lead				
1	Curb	} Cock Valve T.S. & V.	3/4 in. Oriseal	\$	
1	Service box		} Short 3 1/2 x 4 1/2 Long 4 1/2 x 5 1/2		
	Old returned			Buff or Rdway	\$
30	Ft. 3/4 in.	} Copper G.I. C.I.	Pipe at	\$	
	Nipples		in. at	\$	
	Bushings		to in. at	\$	
	Red'g	} Coupl'gs	to in. at	\$	
	Inc'g				
	Union	in. at	\$		
	Meter	in. at	\$		
	Lead Joints	at	\$		
	Compound Joints	at	\$		
	Maintenance Foreman		\$		
	Hrs. Water Maint. Man-1	at	\$		
	Hrs. Water Maint. Man-2	at	\$		
	Hrs. Garage Foreman	at	\$		
	Hrs. Labor	at	\$		
	Hrs. Compressor	at	\$		
	Compensation Ins. at \$	per C	\$		
	Trucking		\$		
	Pav't Patch		\$		
	Tap by Giffard		\$		
	Tap Miller & Co.		\$		
	5-25-65		\$		
	O'head		\$		

Haskell

St. Pl. Ave. No. 24

Name of Owner

Labor and Mat'l. Report May 21 1965

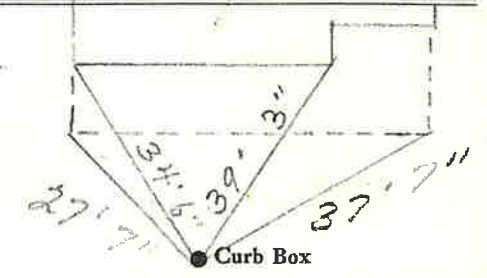

6' Main Elev. of Main at tap 5'

Gate at • Gate at

• Curb Box