

LABOR AND MATERIALS

Copper	} Connection _____	\$ _____	
Lead			
Curb	} Cock Valve } _____ in. _____	\$ _____	
			T. S. & V.
Service box	} Short 3½ x 4½ } _____	\$ _____	
Old returned			Long 4½ x 5½ } _____
			Buff or Rdway } _____
Ft. _____ in. _____	{ Copper G. I. C. I. } Pipe at _____	\$ _____	
Nipples _____ in. at _____		\$ _____	
Bushings _____ to _____ in. at _____		\$ _____	
Red'g } Inc'g }	Coupl'gs _____ to _____ in. at _____	\$ _____	
Union _____ in. at _____		\$ _____	
Meter _____ in. at _____		\$ _____	
Lead Joints at _____		\$ _____	
Compound Joints at _____		\$ _____	
Maintenance Foreman _____		\$ _____	
Hrs. Water Maint. Man-1 at _____		\$ _____	
Hrs. Water Maint. Man-2 at _____		\$ _____	
Hrs. Garage Foreman _____ at _____		\$ _____	
Hrs. Labor— _____ at _____		\$ _____	
Hrs. Compressor at _____		\$ _____	
Compensation Ins. at \$ _____ per C _____		\$ _____	
Trucking _____		\$ _____	
Pav't Patch _____		\$ _____	
_____		\$ _____	
_____		\$ _____	
_____		\$ _____	
O'head _____		\$ _____	


HASKEL

St. \_\_\_\_\_  
Pl. \_\_\_\_\_  
Ave. No. 22

Name of Owner

JOHN

Labor and Mat'l. Report July 29 1981

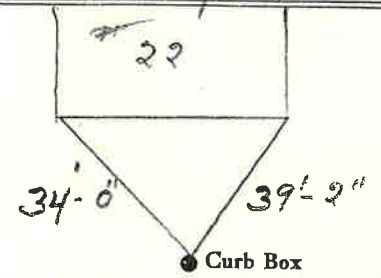

Main \_\_\_\_\_ Elev. of Main at tap \_\_\_\_\_  
Gate at • \_\_\_\_\_ Gate at • \_\_\_\_\_

• Curb Box