

### LABOR AND MATERIALS

Copper	}	Connection		\$	
Lead					
Curb	}	Cock	} in.	\$	
		Valve			
		T. S. & V.			
Service box	}	Short 3½ x 4½	} _____	\$	
Old returned		Long 4½ x 5½			
		Buff or Rdway			
Ft. _____	}	Copper	} Pipe at _____	\$	
in. _____		G. I.			
		C. I.			
Nipples	in. at _____	\$			
Bushings	to _____ in. at _____	\$			
Red'g	}	Coupl'gs	} to _____ in. at _____	\$	
Inc'g					
Union	in. at _____	\$			
Meter	in. at _____	\$			
Lead Joints	at _____	\$			
Compound Joints	at _____	\$			
Maintenance Foreman		\$			
Hrs. Water Maint. Man-1	at _____	\$			
Hrs. Water Maint. Man-2	at _____	\$			
Hrs. Garage Foreman	at _____	\$			
Hrs. Labor	at _____	\$			
Hrs. Compressor	at _____	\$			
Compensation Ins. at \$ _____	per C	\$			
Trucking		\$			
Pav't Patch		\$			
		\$			
		\$			
O'head		\$			
		\$			

St. \_\_\_\_\_  
Pl. \_\_\_\_\_  
Ave. No. 24


HASKEL

Name of Owner

JOHN

Labor and Mat'l. Report

July 29 19 81

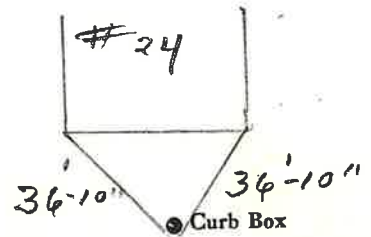

	Elev. of
Main	Main at tap _____
Gate at ●	● Gate at _____

● Curb Box