

LABOR AND MATERIALS

Copper	} Connection	_____	\$ _____	
Lead				
Curb	} Cock Valve T. S. & V. }	_____ in.	\$ _____	
Service box		} Short 3½ x 4½ Long 4½ x 5½ Buff or Rdway }	_____	\$ _____
Old returned				
Ft. _____ in.	} Copper G. I. C. I. }	Pipe at _____	\$ _____	
Nipples _____ in.		at _____	\$ _____	
Bushings _____ to _____ in.		at _____	\$ _____	
Red'g } Inc'g }	} Coupl'gs _____ to _____ in.	at _____	\$ _____	
Union _____ in.		at _____	\$ _____	
Meter _____ in.	at _____	\$ _____		
Lead Joints	at _____	\$ _____		
Compound Joints	at _____	\$ _____		
Maintenance Foreman	_____	\$ _____		
Hrs. Water Maint. Man—1	at _____	\$ _____		
Hrs. Water Maint. Man—2	at _____	\$ _____		
Hrs. Garage Foreman	at _____	\$ _____		
Hrs. Labor—	at _____	\$ _____		
Hrs. Compressor	at _____	\$ _____		
Compensation Ins. at \$ _____	per C _____	\$ _____		
Trucking	_____	\$ _____		
Pav't Patch	_____	\$ _____		
_____		\$ _____		
_____		\$ _____		
_____		\$ _____		
O'head	_____	\$ _____		
		\$ _____		


St.
Pl.
Ave. No. 26

HASKEL

Name of Owner

JOHN

Labor and Mat'l. Report JULY 29 1981

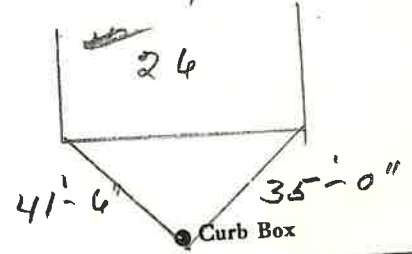

Main Elev. of
Main at tap

Gate at • • Gate at

• Curb Box