

Labor and Materials

| | | | |
|----|--|----------------|-----------|
| 1 | Copper } Connection..... | 3/4 | \$ 1.75 |
| | Lead } | | |
| 1 | Curb { Cock Valve T.S.&V. } .. 3/4 in | | \$ 1.70 |
| 1 | Service Box { Short 3 1/2 x 4 1/2 } | | \$ 1.37 |
| | Old returned { Long 4 1/2 x 5 1/2 } | | |
| | | Buff. or Rdway | |
| 9 | Ft. 3/4 in. { Copper Galv. Iron } Pipe at 12 lbs. | | \$ 1.27 |
| | | Cast Iron | |
| | Nipples | in. at | \$ |
| | Bushings | to | in. at \$ |
| | Red'g } Couplings..... | to | in. at \$ |
| | Inc'g } | | |
| | Union..... | in. at | \$ |
| | Meter..... | in. at | \$ |
| | Lbs. Br. Stone at | | \$ |
| | Lbs. Sand at | | \$ |
| | Bags Cement at | | \$ |
| | Paving Brick { Mack Red Asphalt } at | | \$ |
| | Lead Joints at | | \$ |
| | Leadite Joints at | | \$ |
| 3 | Hrs. Foreman at | 6.75 | \$ 1.98 |
| 16 | Hrs. Common Labor at | 4.5 | \$ 7.20 |
| | Hrs. Common Labor at | | \$ |
| | Hrs. Mason at | | \$ |
| | Hrs. Masons Helper at | | \$ |
| | Hrs. Compressor at | | \$ |
| | Compensation Ins | | \$.34 |
| | Trucking | | \$ 1.- |
| | Builders Use of Water | | \$ |

Total \$ 159.6...


1935-170

Labor and Material Report

Cent 7

19

27 Haskell Ave

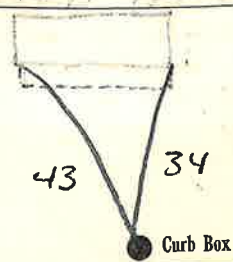

6 Main

Elev. of Main at tap

Gate at ●

● Gate at

● Curb Box

*old
Shut off at main
to be paid for*

MD