


Labor and Materials

Copper	} Connection.....	?	\$ 1.50
Lead			
Curb	} { Cock Welded T.S. & V. }	in	? \$ 1.70
Service Box		} { Short 3 1/2 x 4 1/2 Long 4 1/2 x 5 1/2 Buff. or Rdway }	
Old returned			\$ 1.44
27 Ft.....	in. { Copper Galv. Iron Cast Iron } Pipe at		
Nipples	in. at	\$
Bushings	to in. at	\$
Red'g Inc'g	} Couplings.....	to.....	in. at
Union.....		in. at	\$
Meter.....	in. at	\$	
Lbs. Br. Stone	at	\$	
Lbs. Sand	at	\$	
Bags Cement	at	\$	
Paving Brick	} { Mack Red Asphalt }	at	\$
Lead Joints		at	\$
Leadite Joints		at	\$
6 Hrs. Foreman	at	6 1/2	\$ 3.75
1 Hrs. Common Labor	at	50	\$ 50
9 Hrs. Common Labor	at	45	\$ 4.05
Hrs. Mason	at		\$
Hrs. Masons Helper	at		\$
Hrs. Compressor	at		\$
Compensation Ins		\$ 0.30
Trucking		\$ 2.-
Builders Use of Water	Part Patch		\$ 5.-
Total \$			25.27

28 HASKELL

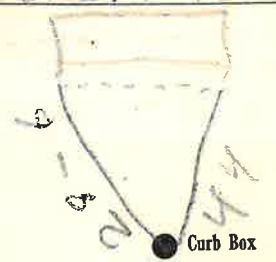

6 Main Elev. of Main at tap 4
Gate at ● Gate at ●

● Curb Box

old cap
Disconnected
to be paid Wednesday
No Patch Charge

173 40